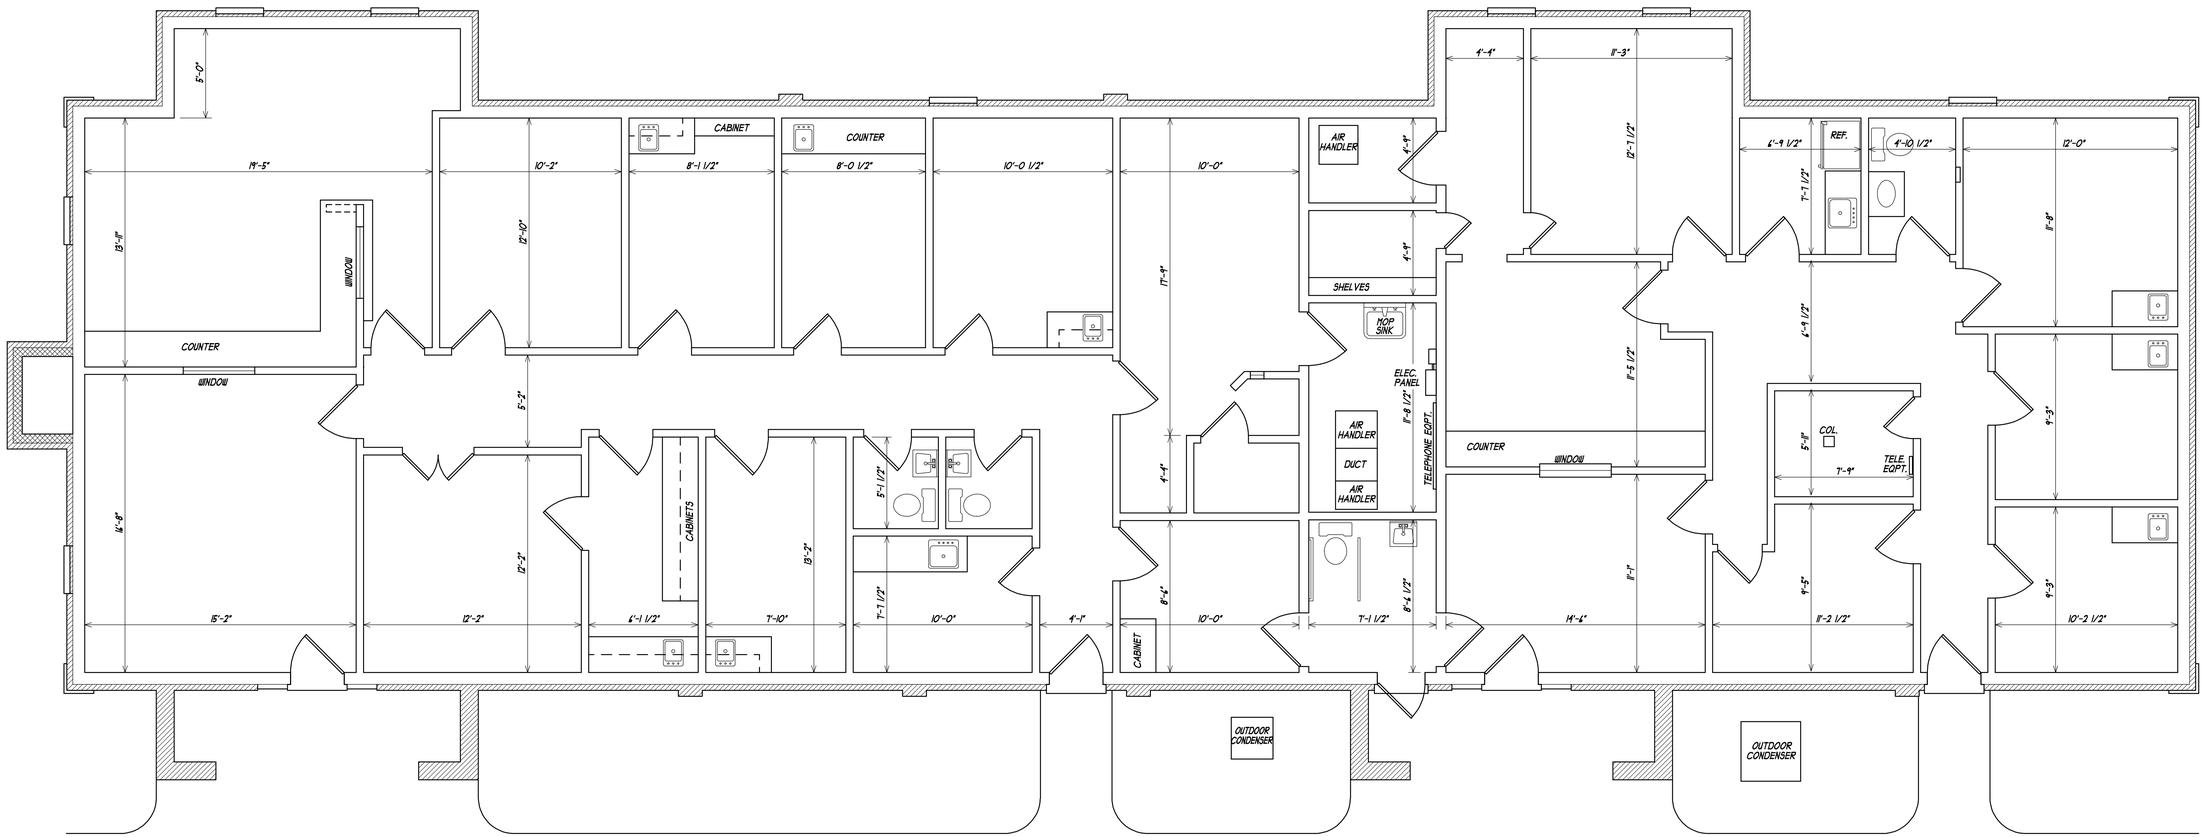

UPPER LEVEL FLOOR PLAN

1/4" = 1'-0"

Blue Ridge Architecture
6 1/2 Wall Street, Martinsville, VA 24112
Tel: 276.638.3948 Fax: 276.666.4088 Email: blueridgearch@gmail.com

Thursday, April 10, 2008

COMM. NO.	DATE	REVISION
NO.	DATE	

AS-BUILT DRAWINGS OF OFFICE BUILDING FOR

The Lester Group

FAIRY STREET EXTENSION MARTINSVILLE, VIRGINIA

UPPER LEVEL FLOOR PLAN

DRAWING

A-1

OF